
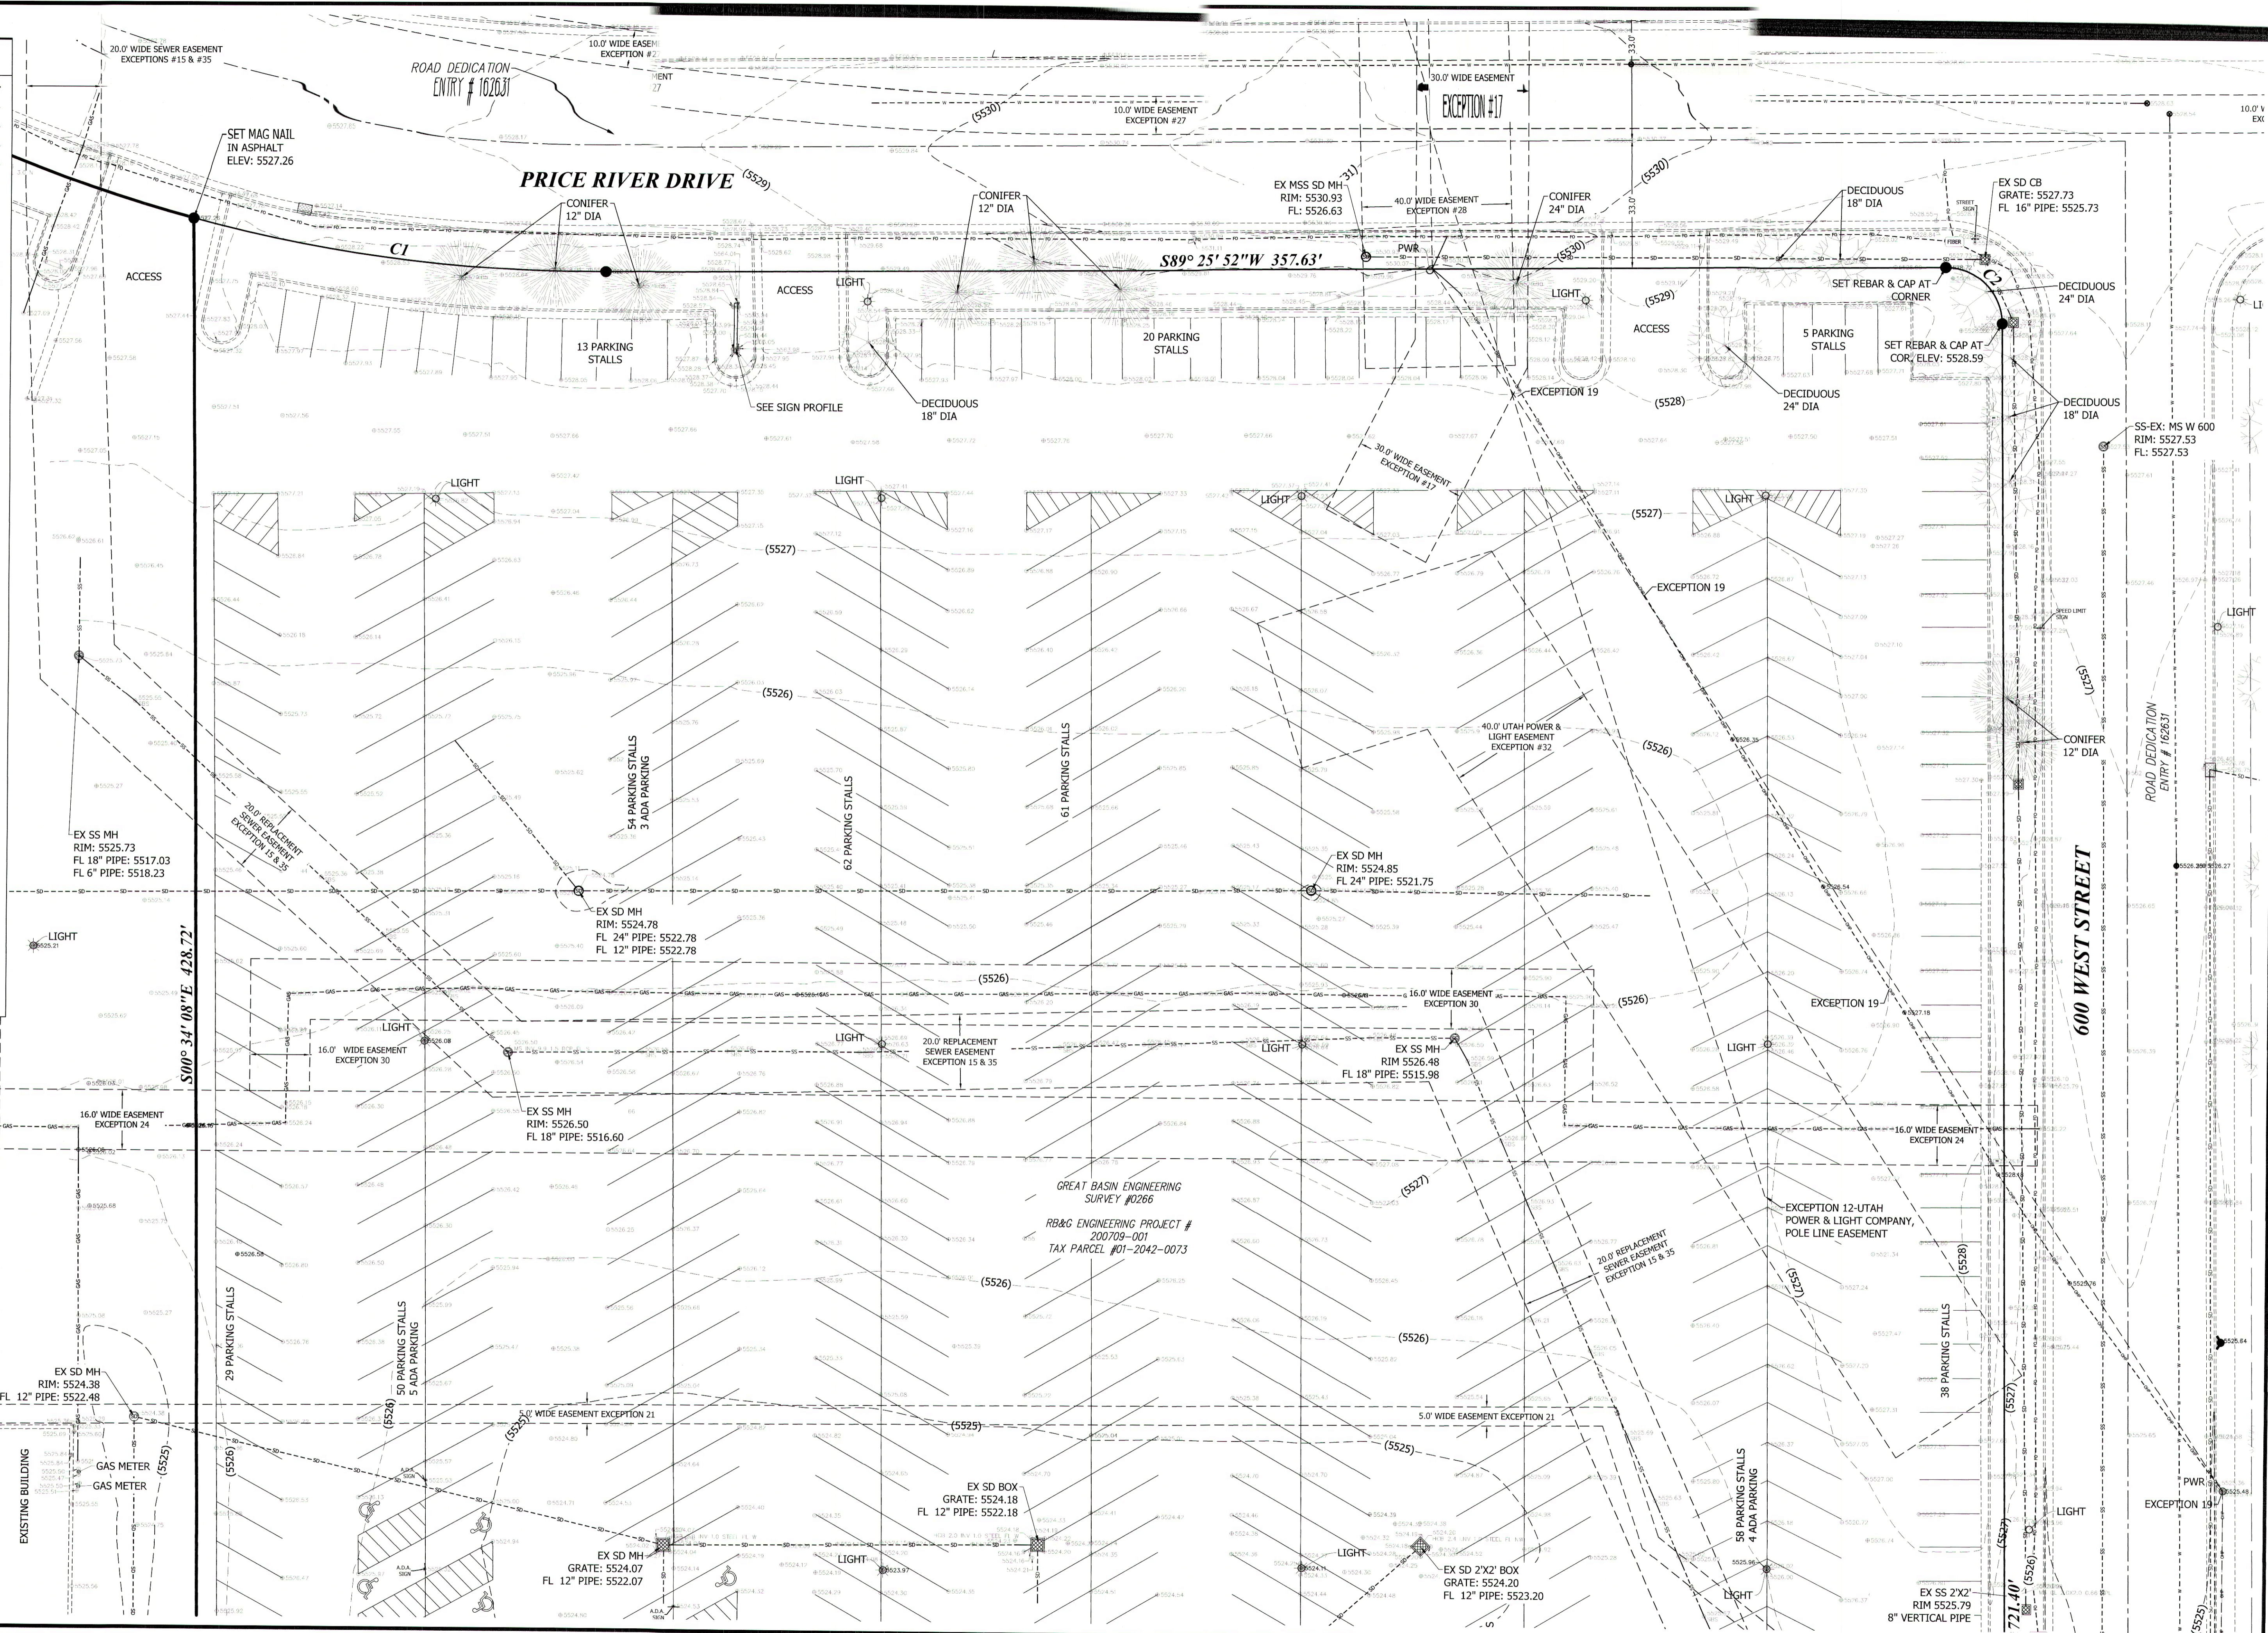


LEGEND

- PROPERTY LINE
- ADJACENT PROPERTY SECTION LINE
- TIE TO MONUMENT
- EASEMENT LINE
- EDGE OF PAVEMENT
- CURB, GUTTER, SIDEWALK
- BUILDING
- BLOCK WALL
- CHAIN LINK FENCE
- INDEX 1-FOOT CONTOUR
- MINOR 1-FOOT CONTOUR
- UNDERGROUND POWER LINE
- STORM DRAIN LINE
- SANITARY SEWER LINE
- CULINARY WATER LINE
- GAS LINE
- OVER HEAD POWER LINE
- FIBER OPTIC LINE
- FIBER OPTIC BOX
- COMMUNICATION BOX
- ELECTRIC TRANSFORMER
- IRRIGATION BOX
- FIBER OPTIC JUNCTION BOX
- ELECTRICAL CONTROL BOX
- POWER POLE
- LIGHT POLE
- SANITARY SEWER MANHOLE
- STORM DRAIN MANHOLE
- WATER MANHOLE
- STORM DRAIN CATCH BASIN
- FIRE HYDRANT
- WATER/IRRIGATION VALVE
- A.D.A STALL
- TREE
- RECORD CALLS ()
- SET 5/8" REBAR WITH H&A ENTELLUS CAP, LS #166385, AT CORNER (UNLESS OTHERWISE NOTED)
- FOUND PROPERTY MARKER (AS NOTED)

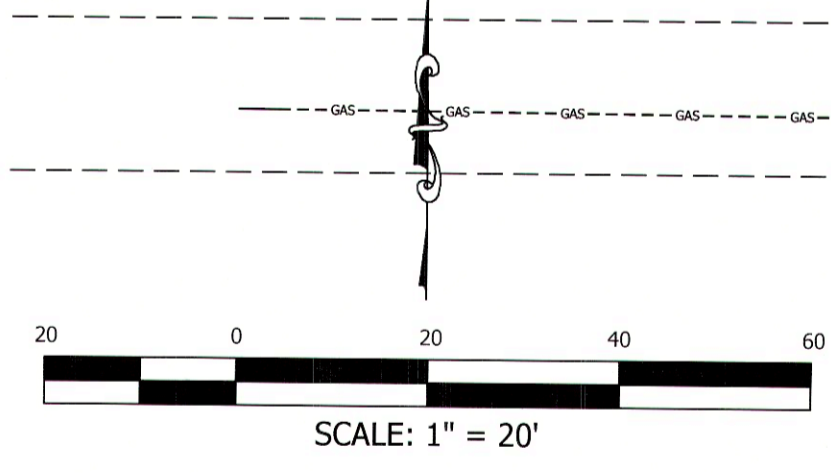

SHEET 3 OF 4
ALTA/NSPS SURVEY

DRAWN:	05/24/2019	REV #1 BY: JH 06/14/2019 NEW TITLE REPORT
REV: JRC	06/25/2019	REV #2 BY: JH 06/24/2019 CLIENT REDLINES
PROJECT #:	1478002	
	ALTA 1478002.dwg	

ALTA/NSPS LAND TITLE SURVEY FOR:
AMERCO REAL ESTATE COMPANY
 ENTITY #720073
610 WEST PRICE RIVER DRIVE
 TAX PARCEL #01-2042-0073 & #01-2042-0075
 LOCATED IN THE N/4 OF SECTION 20, T.14S., R.10E., S.L.B.&M.
 PRICE CITY CITY, CARBON COUNTY COUNTY, UTAH

1470 South 600 West
 Woods Cross, UT 84010
 Phone 801.298.2236
 www.Entellus.com